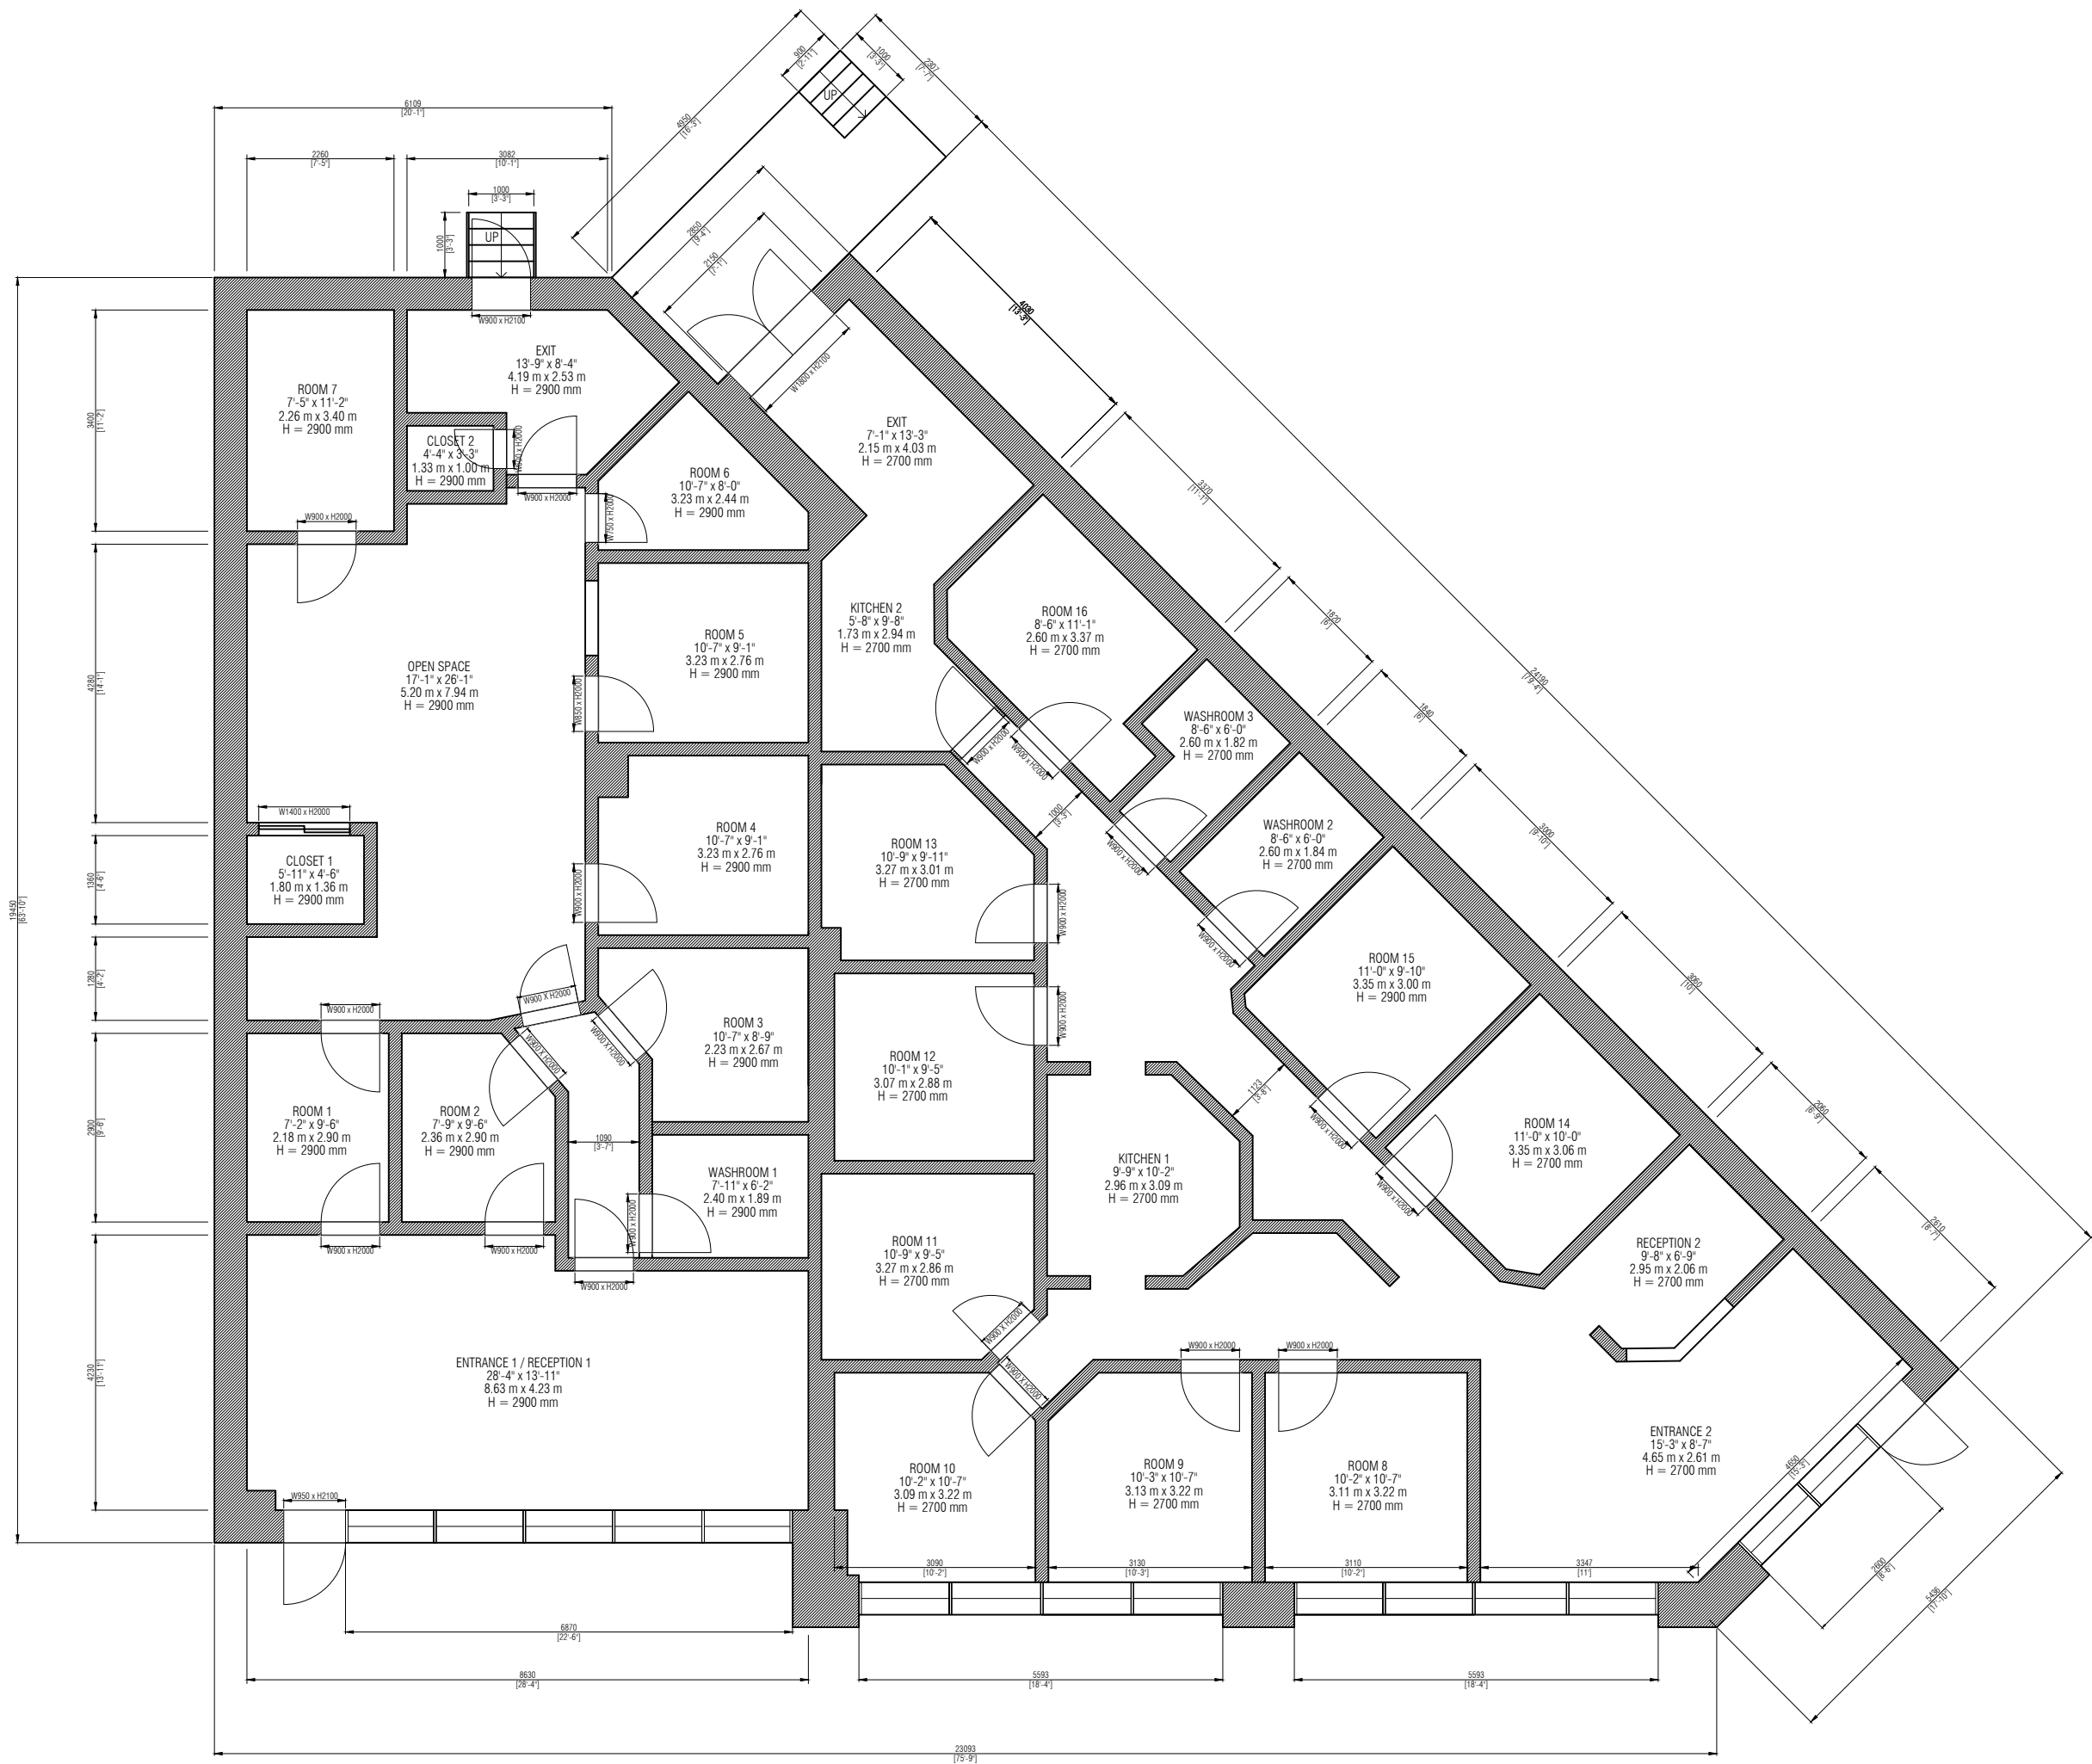


Project Name

237 MAPLEVIEW DR E,
BARRIE, ON

Address

237 MAPLEVIEW DR E,
BARRIE, ON

Notes

This floor plan has been created from a Matterport MC250 Pro2 (accurate within +/- 2% within 15' from scan positions).

While every attempt has been made to ensure the accuracy of the floor plan, Sky Sight Aerial Solutions Inc. assumes no liability for any errors, omissions, or misstatements. This plan is for illustrative purposes and should only be used as such.

No.	Revision/Issue	Date

Project Name

237 MAPLEVIEW DR E,
BARRIE, ON

Project Type

GROUND FLOOR PLAN
(AS-BUILT)

Date

10 - 29 - 2022

Scale

1:100

Sheet Number

A1